CLICK TO VIEW
VIRTUAL TOUR

FOUNDATION KEYNOTES

1. REFER TO DETAIL 105/S4.1 FOR THICKNED SLAB AT STAIR

REFER TO SHEET S0.1 FOR FOUNDATION PLAN NOTES, FOUNDATION KEYNOTES, AND SCHEDULES

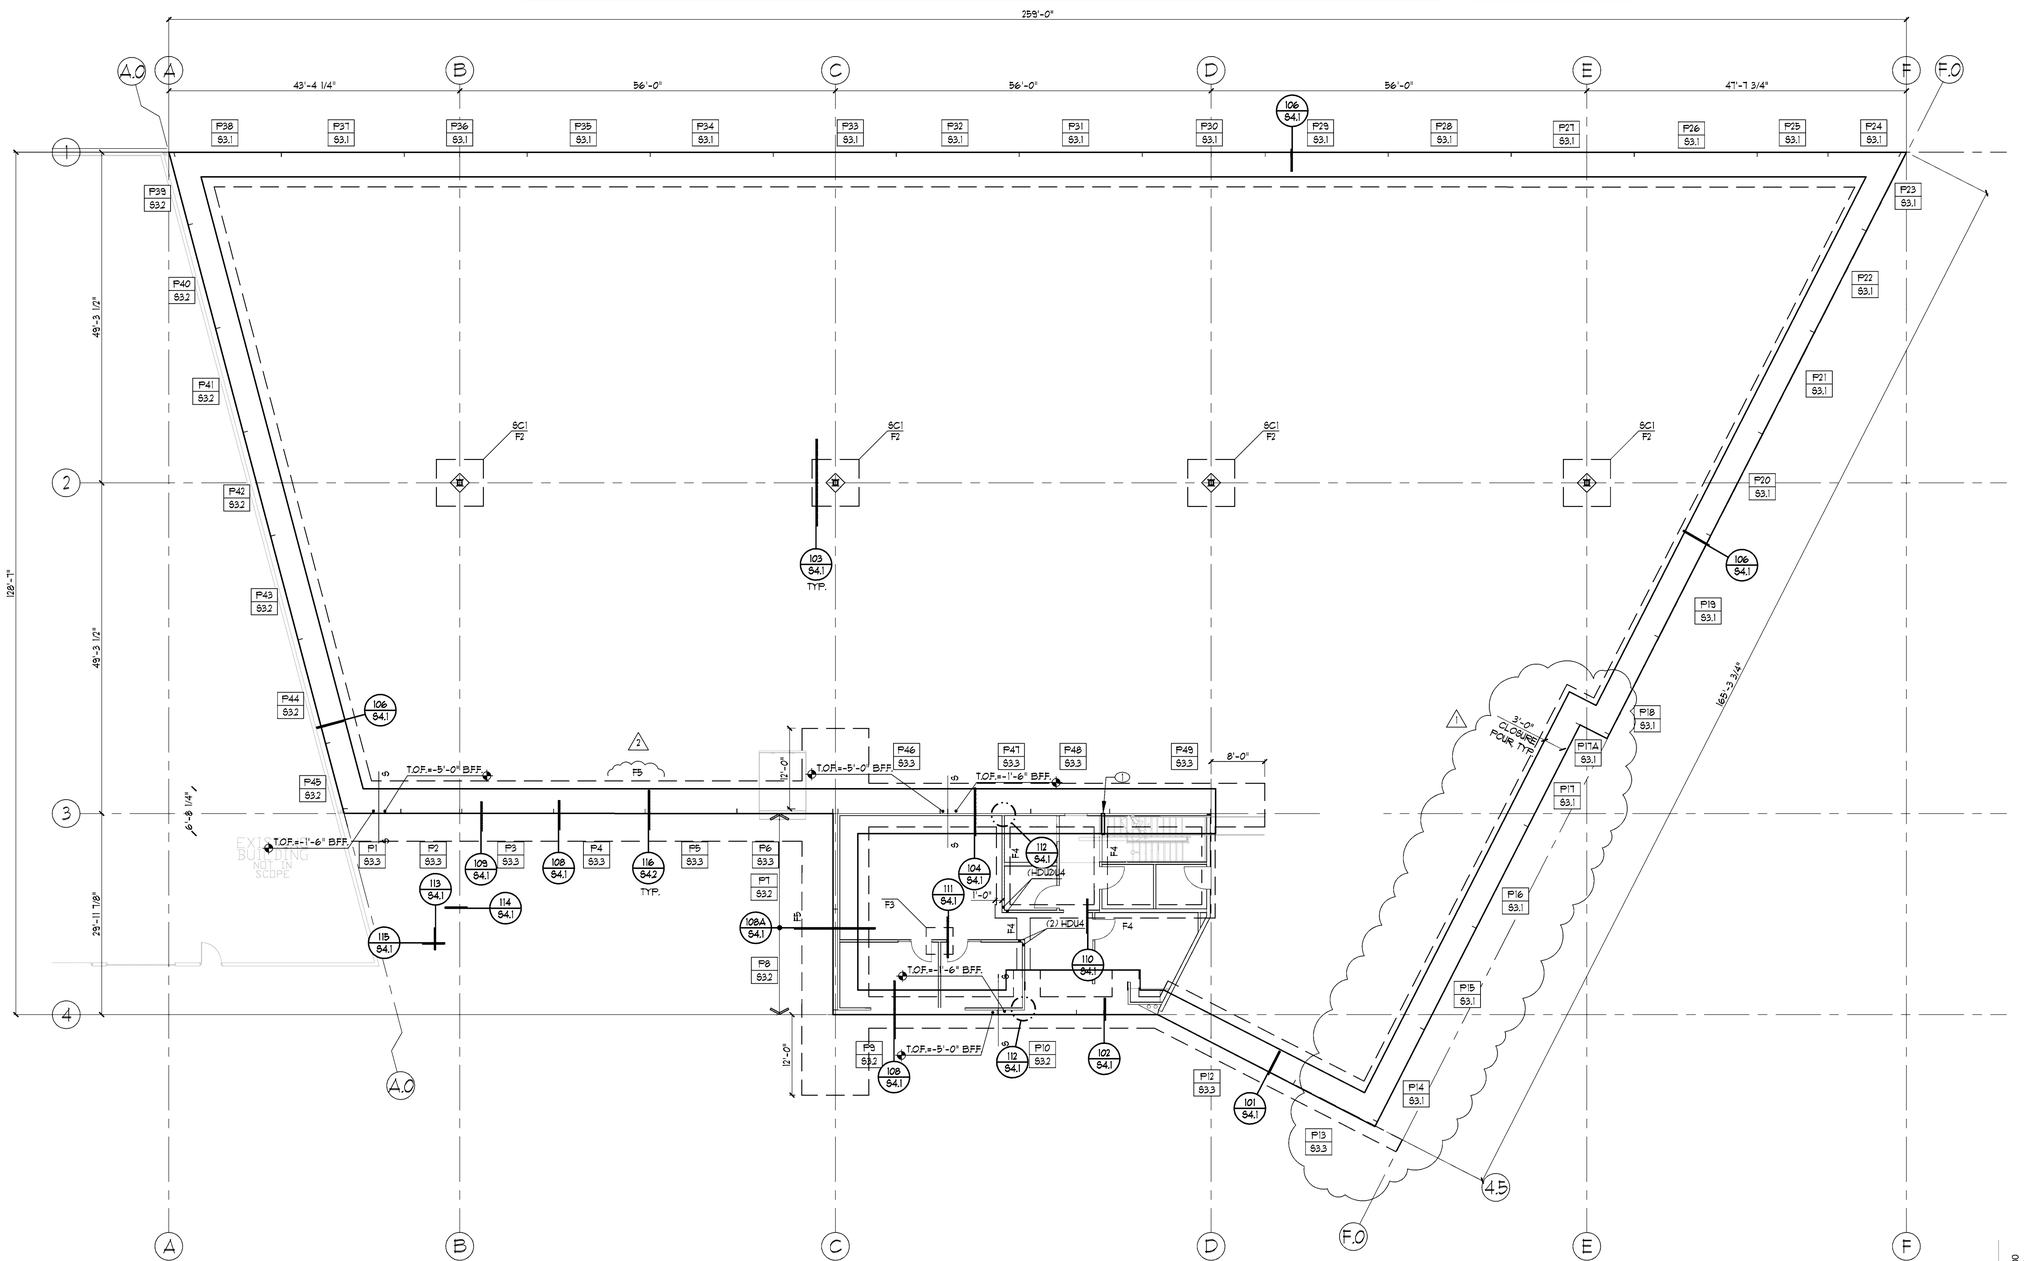

FOUNDATION PLAN

SCALE: 3/32" = 1'-0"

WRIGHT engineers
2 Venture Suite 200
Irvine, CA 92618
949.477.4001 wrightengineers.com
S11-160881-PS

aptus
copyright 2016 © by aptus
1200 South 4th Street
Suite 206
Las Vegas, Nevada
89104
P 702.839.1200
F 702.839.1213

Sorensen Flex Warehouse
Development Plan Approval
8940 Sorensen Avenue
Santa Fe Springs, California, 90670

REGISTERED PROFESSIONAL ENGINEER
THOMAS ALLEN
No.55460
STRUCTURAL
STATE OF CALIFORNIA
7/17/2018

Plan check issue/mittal	7.24.18
City of Santa Fe Springs Fire Access	5.25.18
Owner Review	1.19.17

TITLE

FOUNDATION PLAN

DRAWING NO.

S1.1

216.007 Sorensen Flex Warehouse